

CERTIFICATE OF LOCATION OF GOVERNMENT CORNER

NORTHEAST Corner of Section 21, Township 115, Range 41, 5TH P.M.

STATE OF MINNESOTA, County of YELLOW MEDICINE


At the corner location shown on the sketch:

On 10-26-2007 found a TWISTED IRON ROD

left monument as found, lowered monument, removed monument (explain)

On _____ placed a _____

SKETCH OF REFERENCE TIES

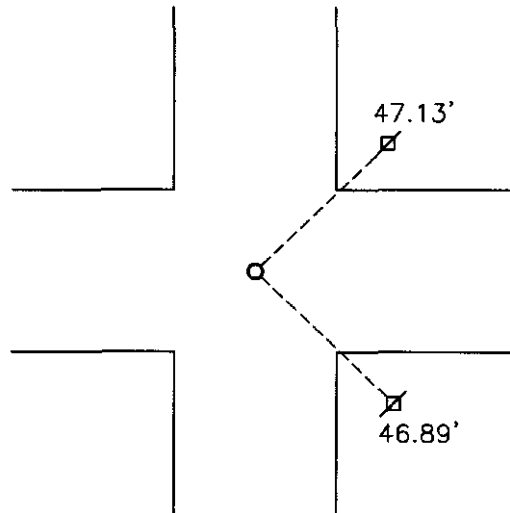

Minnesota State Plane Coordinate
System Yellow Medicine County Datum
NAD83 (1996)

N: 180161.004
E: 529082.676

Nail and bottle cap in power pole NE 47.13'
Nail and seal in power pole SE 46.89'

Statement of evidence relative to this corner location is on back of page.

I hereby certify that this document and the data contained herein was prepared by me or under my direct supervision.

Samuel B... Feb. 20, 2008
SIGNATURE DATE

Registration No. 43844

Land Surveyor, Professional Engineer
 County Surveyor, County Engineer

OFFICE OF THE COUNTY RECORDER

County of _____

I hereby certify that this document was filed in the Co. Recorders office at _____ M on the _____ day of _____ A.D. 20 _____

County Recorder _____

By _____, Deputy

DOCUMENT NO. _____

Statement of Evidence

In 1864, Chas E. Davis and J.W. Webb, Jr., did the original subdivision of the township.

In 1940, the Yellow Medicine Highway Department located a monument at the corner.

On October 5, 1977, the Yellow Medicine Highway Department found a monument and tied it out.


On October 26, 2007, Bueltel-Moseng Land Surveying found a twisted iron rod at the corner. It was very close to the ties from 1977, and we accepted it as the corner.

N/C Bueltel-Moseng Land Surveying
PO Box 32
Marshall MN 56258

Doc# 245316 Fee: \$0.00 2 Pages

Office of County Recorder
Yellow Medicine County, Minnesota
I hereby certify that the within instrument
was filed on April 8, 2008 at 10:55 AM

Kay Zempel, Yellow Medicine County Recorder

By  Deputy