

CERTIFICATE OF LOCATION OF GOVERNMENT CORNER

NORTHEAST Corner of Section 32, Township 114 N, Range 46 W

5th Principal Meridian, State of Minnesota, County of Yellow Medicine.


At the corner location shown on the sketch:

On _____ found a _____
DATE

left monument as found lowered monument removed monument (explain)

On 10/25/17 placed a 1/2" rebar with cap LS45874
DATE

SKETCH OF REFERENCE TIES

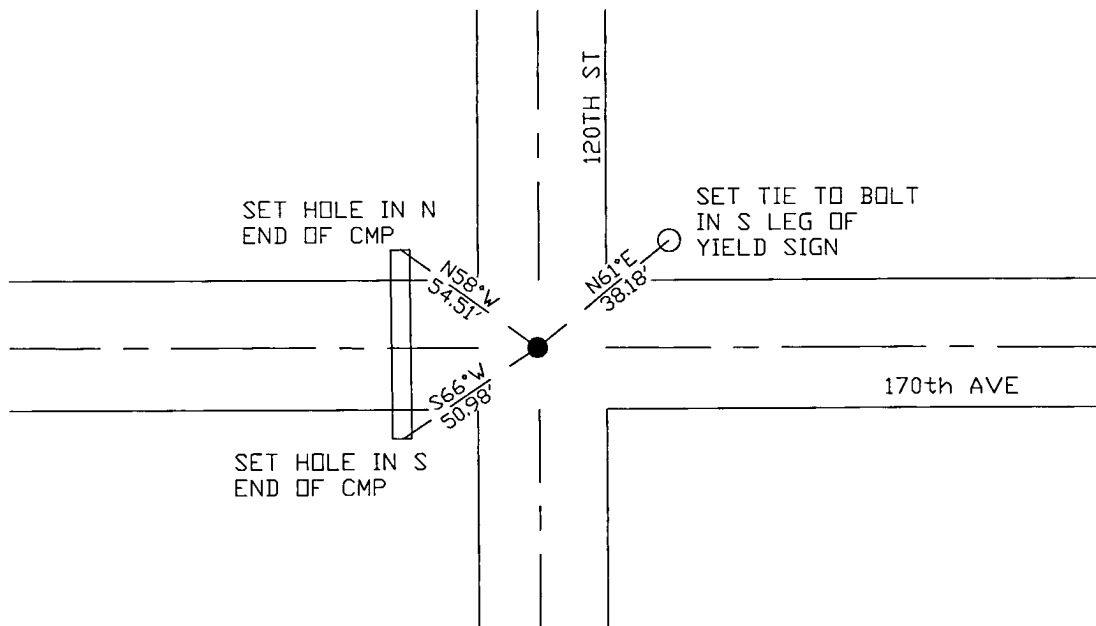

Statement of evidence for this corner location is on back of this page.

I hereby certify that this document was researched and prepared by me or under my direct supervision and that I am a licensed Land Surveyor under the laws of the State of Minnesota.

Signature *[Handwritten Signature]*

Date 3/26/18 License No. 45874

Title:

- Land Surveyor Professional Engineer
 County Surveyor County Engineer

Doc# 268264 Fee: \$0.00 2 Pages

Property & Public Services
 Property Records Division
 Yellow Medicine County, Minnesota
 I hereby certify that the within instrument was filed on April 6, 2018 at 11:15 AM

Janel Timm, Yellow Medicine County Recorder

By *[Handwritten Signature]* Deputy

STATEMENT OF EVIDENCE:

NORTHEAST OF SECTION 32, T114N, R46W, 5TH PM

1871 Corner was originally established by the U.S. General Land Office as a post set in raised mound.

1901 Surveyors Record Book B Page 204 contains a survey completed in which they found the Government Mound in place at the corner location.

1910 Surveyors Record Book page 214 contains a survey in which shows a monument in place at the corner location.

1913 Sureyors Record Book, John Norgaard, County Surveyor completed a survey in which a Jasper stone monument was found at the corner location.

1955 Section Corner Tie Book page 4 from the County Highway Engineers Office shows monument in place with ties as follows:

telephone pole SW 60.2'

second fence post NW 65.7'

power pole NE 60.3'

1959 Section Corner Tie Book page 4 from the County Highway Engineers Office shows monument in place with ties as follows:

power pole NW 69.9'

telephone pole SW 70.5'

power pole NE 60.7'

1977 DNR completed a survey in Section 32 in which a iron pipe was found at the corner location.

2001 MN DNR completed a survey for Sections 33 and 34 in which they set a DNR SURVEY MARKER at the corner location, and completed a corner record dated 06/04/01.

N: 138326.324

E: 364806.877

2017-10-25 Westwood PS searched the area and found nothing. Set 1/2" rebar with cap LS 45874 per 2001 corner record location and set 3 reference ties.